



## **Appendix F**

### **As-Built Drawings with Survey Verification**



# TEXAS GENERAL LAND OFFICE

## IN PARTNERSHIP WITH SCENIC GALVESTON, INC.

### VIRGINIA POINT WETLAND PROTECTION PROJECT

#### GALVESTON COUNTY, TEXAS

PROJECT No. 1596      SEPTEMBER 2016

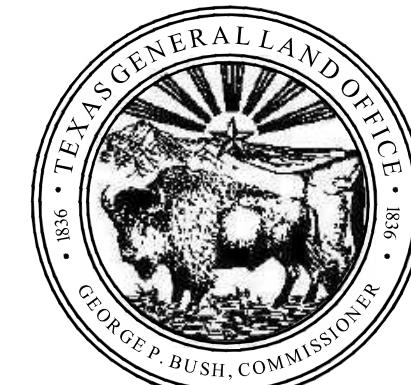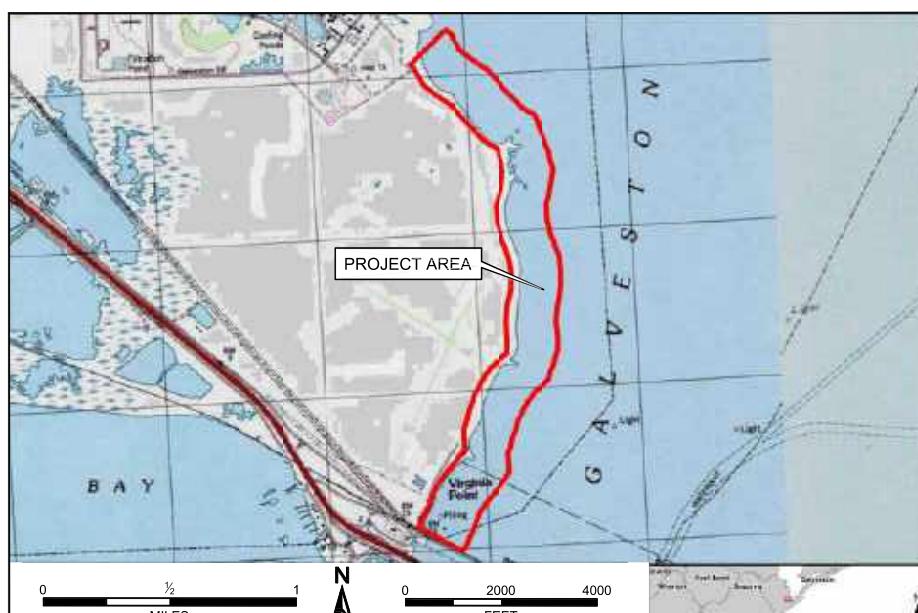

COMMISSIONER  
GEORGE P. BUSH



THIS PROJECT IS FUNDED IN PART BY A FINANCIAL ASSISTANCE AWARD  
FROM THE U.S. DEPARTMENT OF THE INTERIOR, U.S. FISH AND WILDLIFE  
SERVICE, COASTAL IMPACT ASSISTANCE PROGRAM.

TEXAS GENERAL LAND  
OFFICE CONTACT

CARLA KARTMAN  
PROJECT MANAGER  
1700 NORTH CONGRESS AVENUE  
AUSTIN, TEXAS 78701  
PHONE: (512) 463-8753  
FAX: (512) 475-0680

SCENIC GALVESTON  
CONTACT

LALISE MASON  
VICE PRESIDENT & HABITAT  
RESTORATION CHAIRMAN  
20 COLONY PARK CIRCLE  
GALVESTON, TEXAS 77551  
PHONE: (713) 725-8101

DRAWING NO.	DRAWING INDEX
1596-T100	TITLE SHEET
1596-G100	GENERAL ARRANGEMENT
1596-G101	CONSTRUCTION ACCESS & HAUL ROUTES
1596-G102	BREAKWATER COORDINATES - STA. 0+00 TO 20+73
1596-G103	BREAKWATER COORDINATES - STA. 20+73 TO 43+60
1596-G104	BREAKWATER COORDINATES - STA. 43+60 TO 61+93
1596-G105	BREAKWATER COORDINATES - STA. 61+93 TO 81+91
1596-G106	BREAKWATER COORDINATES - STA. 81+91 TO 102+00
1596-C100	SITE PLAN - STA. 0+00 TO STA. 20+73
1596-C101	SITE PLAN - STA. 20+73 TO STA. 43+60
1596-C102	SITE PLAN - STA. 43+60 TO STA. 61+93
1596-C103	SITE PLAN - STA. 61+93 TO STA. 81+91
1596-C104	SITE PLAN - STA. 81+91 TO STA. 102+00
1596-C105	BREAKWATER "A" DETAILS
1596-C106	BREAKWATER "B" DETAILS
1596-C107	REVETMENT "R" AND SIGNAGE DETAILS



AECOM  
FIRM REGISTRATION No. 3580

**AECOM**

19219 KATY FREEWAY, SUITE 100  
HOUSTON, TEXAS 77094  
PHONE: (281) 646-2400  
FAX: (281) 646-2401

PROJECT No. 60433394  
GLO DWG. No: 1596 - T100  
SHEET No. 1 OF 16 SHEETS



8	AS-BUILTS	CL	9/19/16	DRAWING SCALE 1" = 1200'	GENERAL LAND OFFICE / SCENIC GALVESTON, INC.	JOB NO. 60433394
7	ENGINEER'S SUPPLEMENTAL INSTRUCTIONS #3	CL	9/6/16	REFERENCE NAMES	REVISION	
6	ENGINEER'S SUPPLEMENTAL INSTRUCTIONS #2	CL	8/18/16	DESIGNED BY:	TN	8
5	CHANGE ORDER #2 - PROJECT SIGNAGE	CL	7/15/16	DRAWN BY:	NAB	
4	RE-ISSUE FOR BID	CL	10/26/15	CHECKED BY:	CL	
3	ISSUE FOR REVIEW	CL	9/25/15	APPROVED BY:	CL	
2	ISSUE FOR CONSTRUCTION	EL	8/4/14	FILE: G100-G100-GENERAL ARRANGEMENT-BREAKWATER B AND A1-REVISED.DWG	AECOM	DRAWING NO.
1	95 % DESIGN	EL	7/1/14			
0	70 % DESIGN	EL	9/13/13			
REFERENCES	REV	DESCRIPTION	CHECKED BY	DATE	REV	





REF ID	DESCRIPTION	REV	DESCRIPTION	CHECKED BY	DATE	REV	DESCRIPTION	CHECKED BY
File: G:\Projects\SWR\60433	REFERENCES							
							8 AS-BUILTS	CL
							7 ENGINEER'S SUPPLEMENTAL INSTRUCTIONS #3	CL
							6 ENGINEER'S SUPPLEMENTAL INSTRUCTIONS #2	CL
	2 ISSUE FOR CONSTRUCTION		EL	8/6/14	5	CHANGE ORDER #2 - PROJECT SIGNAGE	CL	
	1 95 % DESIGN		EL	7/1/14	4	RE-ISSUE FOR BID	CL	
	0 70 % DESIGN		EL	9/13/13	3	ISSUE FOR REVIEW	CL	

#### REFERENCES

DRAWING SCALE	1" = 1200'	
REFERENCE NAMES		DATE
DESIGNED BY:	TN	8/4/14
DRAWN BY:	NAB	8/4/14
CHECKED BY:	CL	10/26/15
APPROVED BY:	CL	10/26/15
PROJECTS\SWTR\043394\VRGPN\TCON\DWGSS\ACD2016\AS-BULLIT\DWG FILES		
-G101 - CONSTRUCTION ACCESS AND HALL ROUTES DWG		

<p><b>GENERAL LAND OFFICE / SCENIC GALVESTON, INC.</b>  <b>VIRGINIA POINT WETLAND PROTECTION PROJECT</b>  <b>GALVESTON COUNTY, TEXAS</b></p> <p><b>CONSTRUCTION ACCESS &amp; HAUL ROUTES</b></p>	<p>JOB NO. 60433394</p> <p>REVISION <b>8</b></p> <p>DRAWING NO. <b>1596-G101</b></p>
--	--

BREAKWATER NO.	POINT NO.	NORTHING COORDINATE	EASTING COORDINATE	CREST ELEVATION
B1	P1	13691103.480	3275069.753	+3'
	P2	13691094.944	3275081.178	
	P3	13691078.992	3275119.259	+1.5'
	P4	13691063.040	3275157.340	+3'
	P5	13691047.087	3275195.420	+1.5'
	P6	13691031.135	3275233.501	+3'
B2	P7	13691001.759	3275274.808	+3'
	P8	13690979.848	3275295.195	+1.5'
	P9	13690957.936	3275315.582	+3'
	P10	13690936.025	3275335.969	+1.5'
	P11	13690914.114	3275356.356	+3'
B3	P12	13690875.021	3275388.326	+3'
	P13	13690851.678	3275407.169	+1.5'
	P14	13690830.563	3275424.213	+3'
	P15	13690804.991	3275444.854	+1.5'
	P16	13690781.647	3275463.697	+3'
B4	P17	13690739.657	3275495.015	+3'
	P18	13690714.928	3275510.635	+1.5'
	P19	13690690.198	3275526.255	+3'
	P20	13690665.468	3275541.876	+1.5'
	P21	13690640.738	3275557.496	+3'
B5	P22	13690595.603	3275579.470	+3'
	P23	13690568.123	3275591.504	+1.5'
	P24	13690540.642	3275603.538	+3'
	P25	13690513.162	3275615.572	+1.5'
	P26	13690485.681	3275627.606	+3'
B6	P27	13690437.491	3275647.003	+3'
	P28	13690410.686	3275657.399	+1.5'
	P29	13690383.882	3275667.796	+3'
	P30	13690357.078	3275678.192	+1.5'
	P31	13690330.273	3275688.589	+3'
B7	P32	13690276.445	3275714.364	+3'
	P33	13690251.999	3275731.753	+1.5'
	P34	13690227.553	3275749.141	+3'
	P35	13690203.108	3275766.530	+1.5'
	P36	13690178.662	3275783.919	+3'
B8	P37	13690141.926	3275817.216	+3'
	P38	13690121.406	3275839.100	+1.5'
	P39	13690100.886	3275860.984	+3'
	P40	13690080.366	3275882.868	+1.5'
	P41	13690059.847	3275904.751	+3'
A1	P42	13689949.201	3276042.394	+3'
	P43	13689905.255	3276043.262	+1.5'
	P44	13689880.353	3276062.598	+3'
A2	P45	13689852.707	3276064.066	+3'
	P46	13689835.703	3276097.269	+1.5'
	P47	13689791.757	3276098.137	+3'
A3	P48	13688619.943	3276117.732	+3'
	P49	13688686.937	3276125.900	+1.5'
	P50	13688668.250	3276146.604	+3'
	P51	13688549.564	3276167.308	+1.5'
A4	P52	13688530.877	3276188.013	+3'
	P53	13688507.425	3276213.997	+3'
	P54	13689482.477	3276241.870	+1.5'
A5	P55	13689453.829	3276273.381	+3'
	P56	13689430.721	3276299.680	+3'
	P57	13689403.923	3276329.371	+1.5'
	P58	13689377.125	3276359.063	+3'
PROJECT SIGN #1 (FIELD ADJUST AS NECESSARY)				
13691061.447				
3275267.711				
N/A				

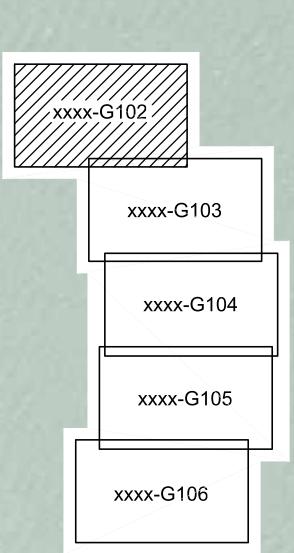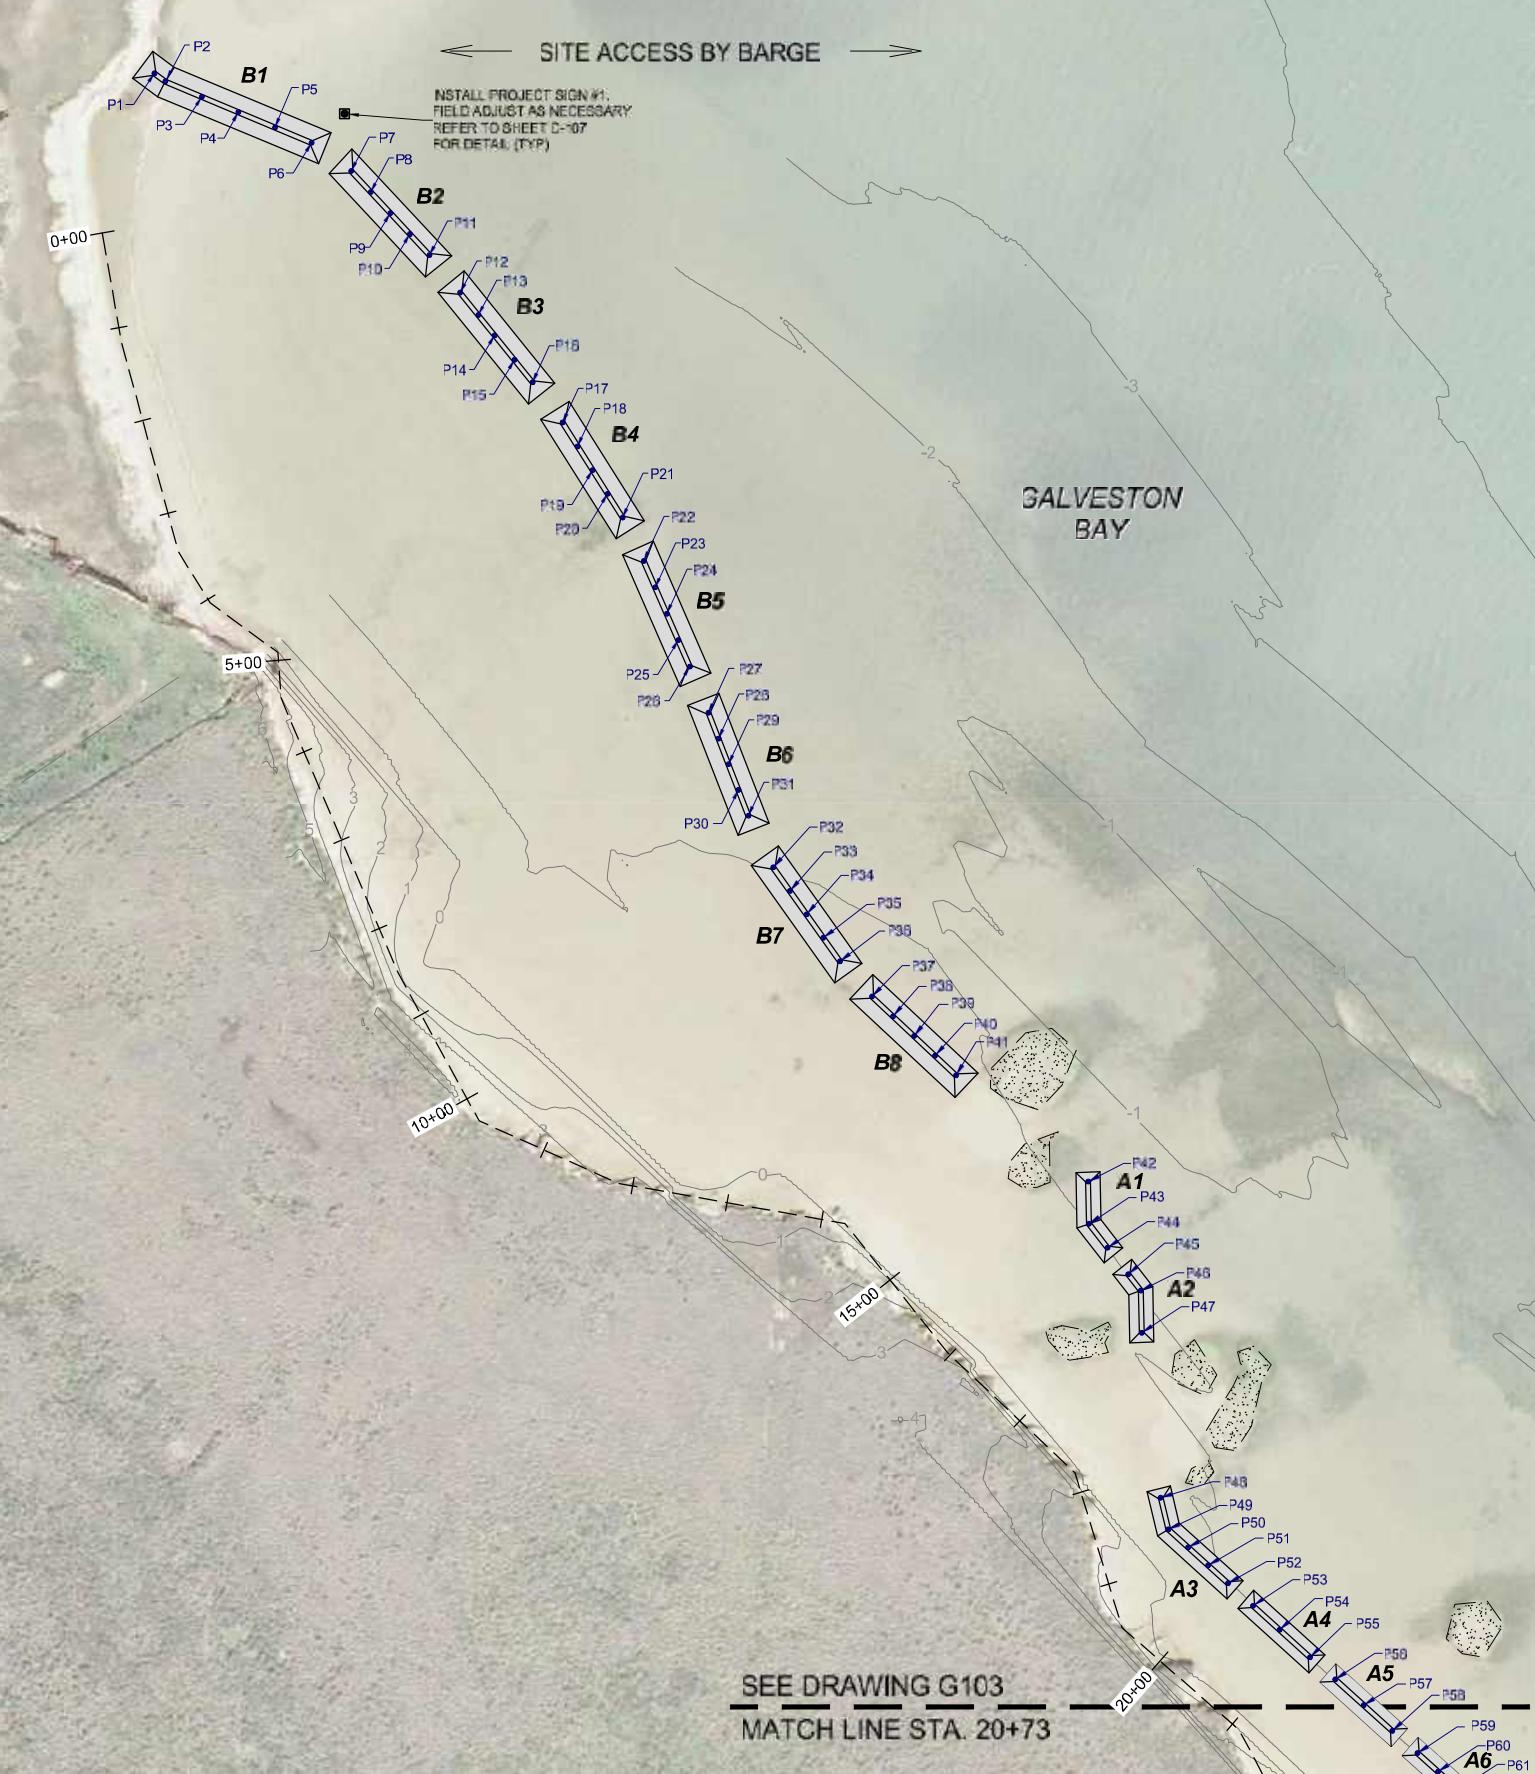


LEGEND:	
A BREAKWATER DESIGNATION	PROJECT SIGN
— Existing Contour (Contour Interval = 1 foot)	
10+00 SURVEY BASELINE STATIONING	
■ BREAKWATER "A" FOOTPRINT	
■ BREAKWATER "B" FOOTPRINT	
■ REVETMENT "R" FOOTPRINT	
■ OYSTER REEFS	
GENERAL NOTES:	
1. SURVEY COMPLETED ON MARCH 10-11, 2013 BY NAISMITH MARINE SERVICES. HORIZONTAL DATUM IS NAD83, TEXAS SOUTH CENTRAL ZONE, US FEET. VERTICAL DATUM IS NAVD'88, US FEET.	
REFERENCE CONTROL MONUMENTS:	
'3200 L 5800' NORTH: 13,691,249.77' EAST: 3,273,882.22' ELEV: 7.33'	
'1488 C 2012' NORTH: 13,680,977.18' EAST: 3,275,184.41' ELEV: 11.93'	
MHHW: 1.03' MLW: -0.02' MLLW: -0.21'	
2. MAINTAIN A BUFFER DISTANCE OF 50 FEET FROM THE OYSTER REEFS AT ALL TIMES.	

7	AS-BUILTS	CL	9/19/16	
6	ENGINEER'S SUPPLEMENTAL INSTRUCTIONS #2	CL	8/18/16	
5	CHANGE ORDER #2 - PROJECT SIGNAGE	CL	7/15/16	
4	RE-ISSUE FOR BID	CL	10/26/15	
3	ISSUE FOR REVIEW	CL	9/25/15	
2	ISSUE FOR CONSTRUCTION	EL	8/4/14	
1	95 % DESIGN	EL	7/1/14	
0	70 % DESIGN	EL	9/13/13	
REFERENCES	REV	DESCRIPTION	CHECKED BY	DATE

DRAWING SCALE 1" = 200'	REFERENCE NAMES	DATE
	DESIGNED BY:	TN
	DRAWN BY:	NAB
	CHECKED BY:	CL
	APPROVED BY:	CL
FILE: PROJECTSWTR6143394_VrgPntCon\DWG\ACAD\2016_As-Built\1596 - G102 - COORDINATES - BREAKWATER B AND A1 - STA 0 TO 20+73.DWG	10/26/15	10/26/15

**AECOM**


GENERAL LAND OFFICE / SCENIC GALVESTON, INC. VIRGINIA POINT WETLAND PROTECTION PROJECT GALVESTON COUNTY, TEXAS	JOB NO. 6043394
REVISION 7	
DRAWING NO. 1596-G102	

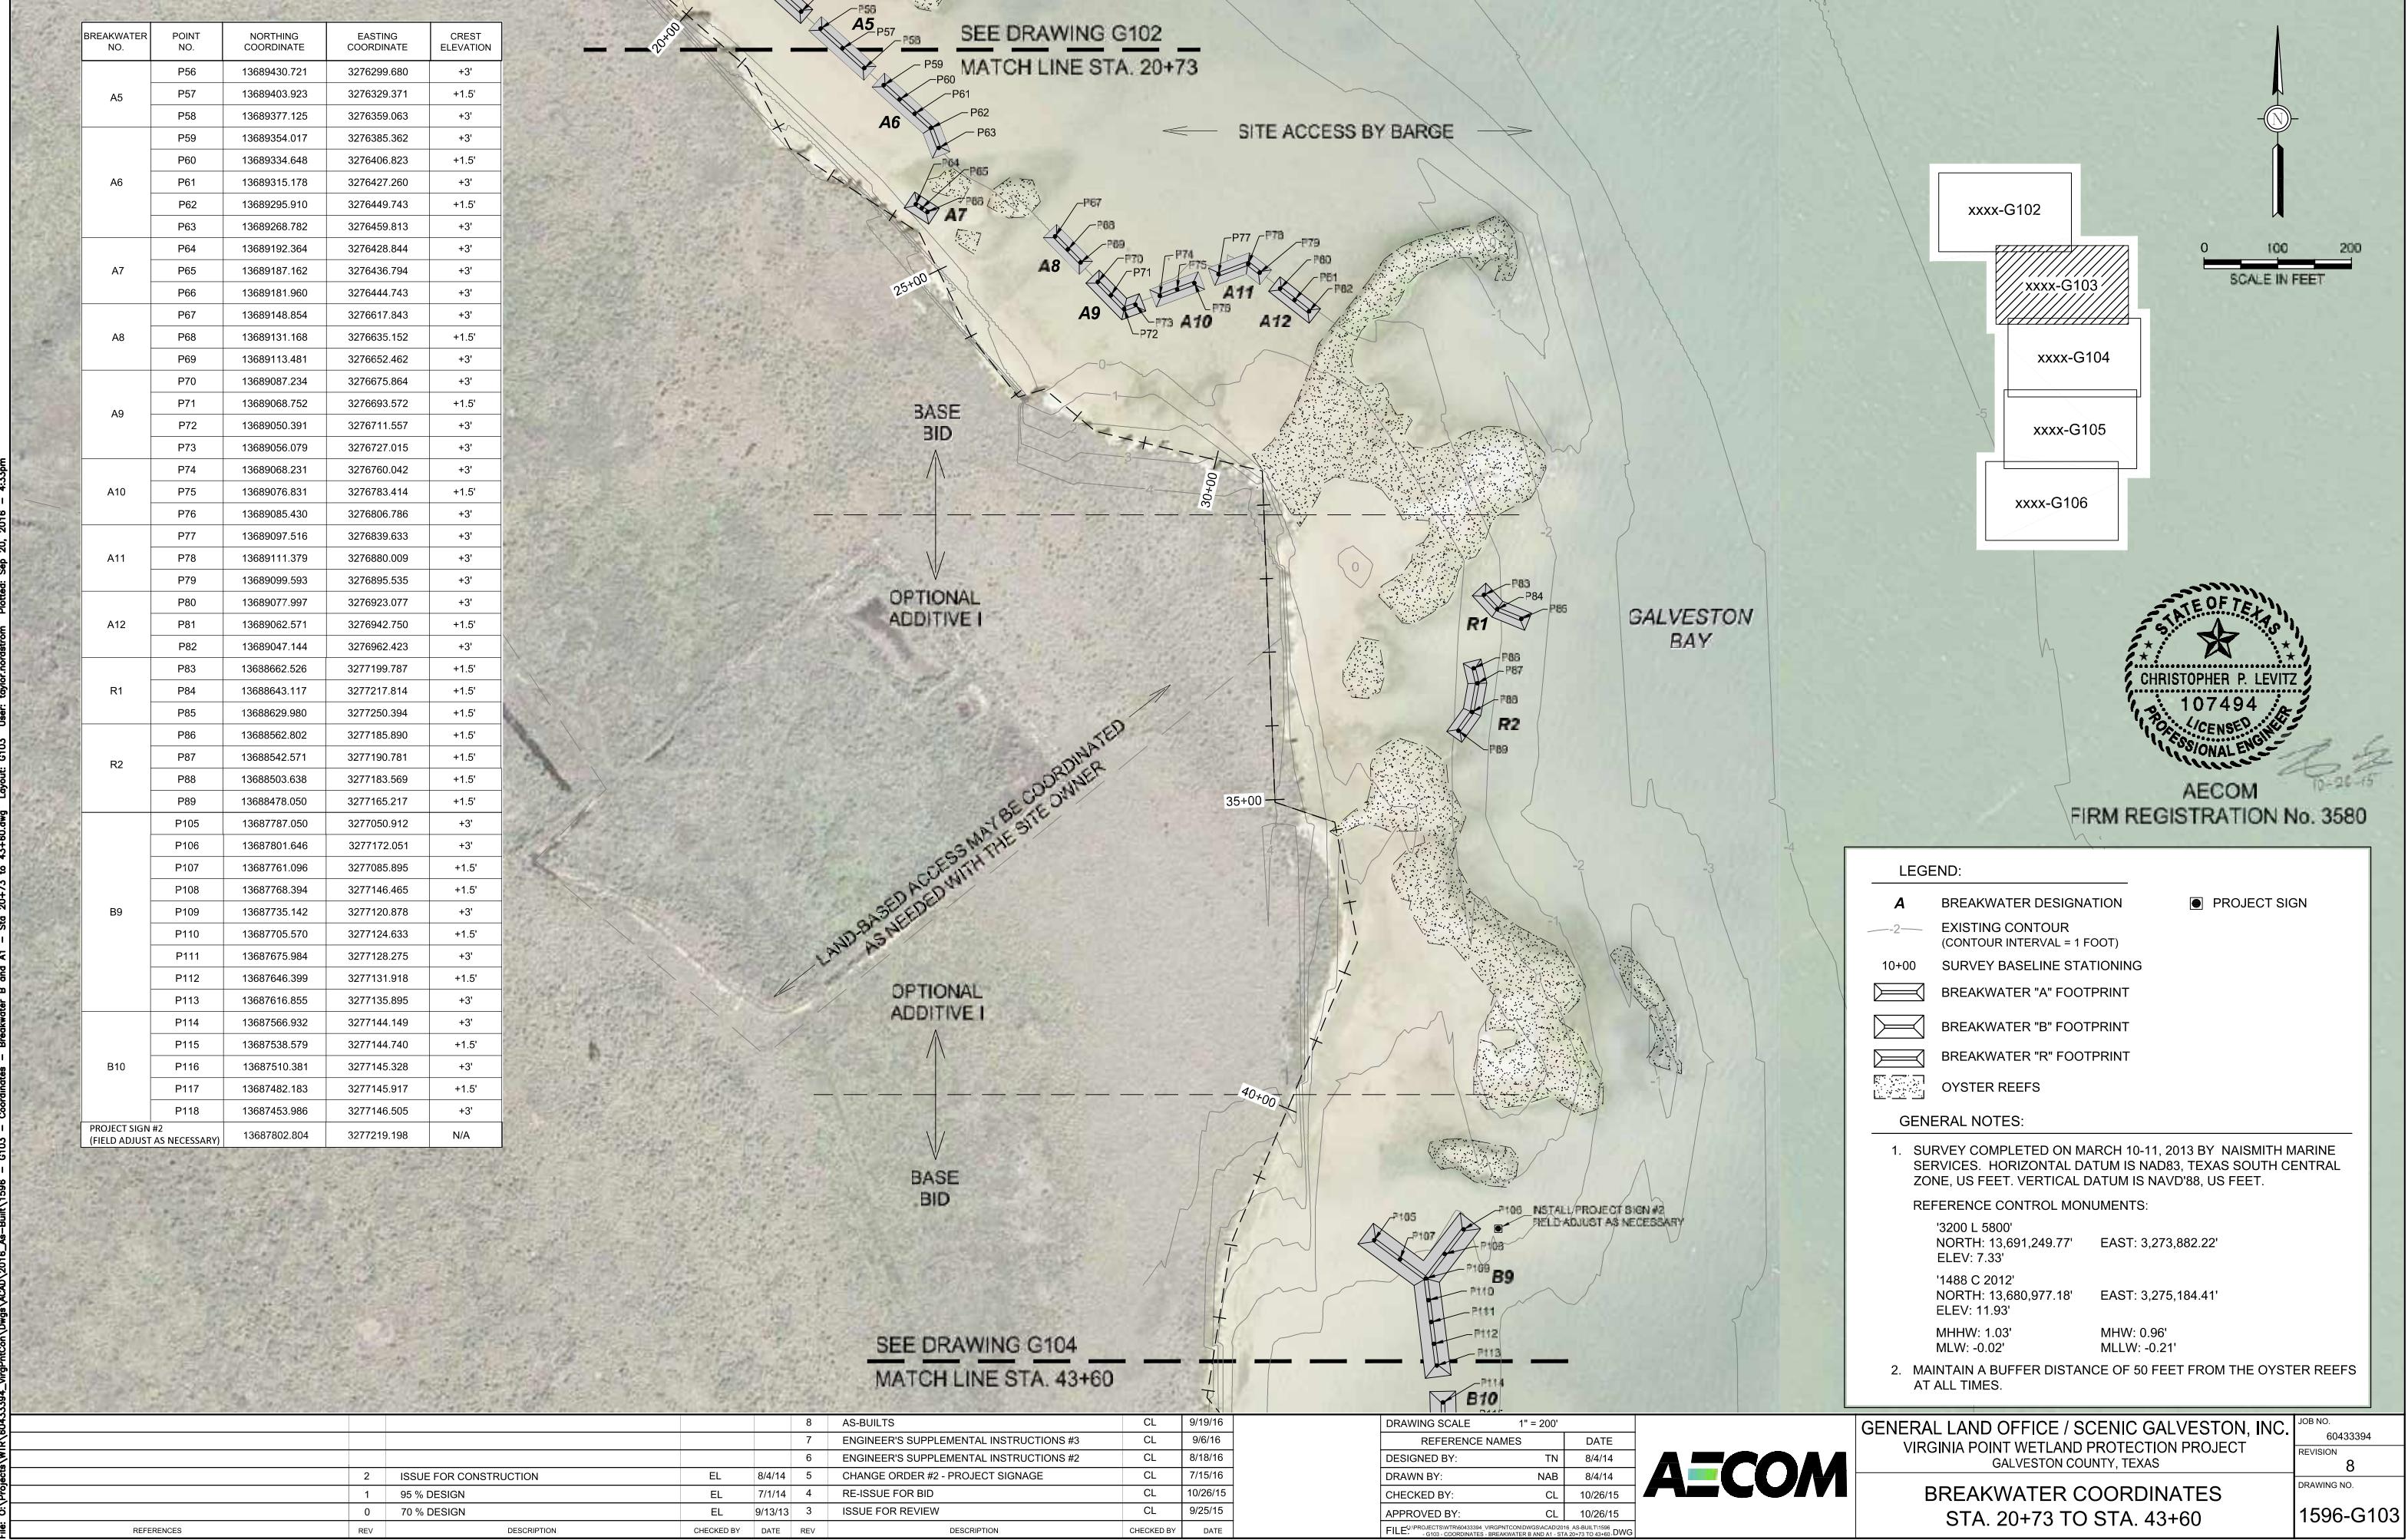



BREAKWATER NO.	POINT NO.	NORTHING COORDINATE	EASTING COORDINATE	CREST ELEVATION
B9	P111	13687675.984	3277128.275	+3'
	P112	13687646.399	3277131.918	+1.5'
	P113	13687616.855	3277135.895	+3'
B10	P114	13687566.932	3277144.149	+3'
	P115	13687538.579	3277144.740	+1.5'
	P116	13687510.381	3277145.328	+3'
	P117	13687482.183	3277145.917	+1.5'
B11	P118	13687453.986	3277146.505	+3'
	P119	13687407.367	3277146.928	+3'
	P120	13687377.396	3277146.479	+1.5'
	P121	13687347.424	3277146.029	+3'
	P122	13687317.453	3277145.580	+1.5'
B12	P123	13687288.628	3277154.165	+3'
	P124	13687245.501	3277167.010	+3'
	P125	13687216.749	3277175.573	+1.5'
	P126	13687187.997	3277184.137	+3'
	P127	13687159.245	3277192.700	+1.5'
B13	P128	13687130.493	3277201.263	+3'
	P129	13687085.845	3277215.511	+3'
	P130	13687058.534	3277224.495	+1.5'
	P131	13687031.223	3277233.479	+3'
	P132	13687003.912	3277242.464	+1.5'
B14	P133	13686976.601	3277251.448	+3'
	P134	13686931.534	3277267.574	+3'
	P135	13686903.958	3277279.388	+1.5'
	P136	13686876.382	3277291.201	+3'
	P137	13686848.806	3277303.015	+1.5'
B15	P138	13686821.230	3277314.829	+3'
	P139	13686779.865	3277332.549	+3'
	P140	13686763.190	3277339.692	
	P141	13686741.319	3277326.651	+1.5'
	P142	13686719.447	3277313.609	+3'
B16	P143	13686697.575	3277300.568	+1.5'
	P144	13686675.704	3277287.526	+3'
	P145	13686637.053	3277264.479	+3'
	P146	13686605.048	3277245.395	+1.5'
	P147	13686573.042	3277226.311	+3'
B17	P148	13686541.037	3277207.227	+1.5'
	P149	13686509.807	3277214.621	+3'
	P150	13686389.143	3277243.188	+3'
	P151	13686370.789	3277247.533	
	P152	13686357.585	3277276.261	+1.5'
B18	P153	13686344.381	3277304.988	+3'
	P154	13686331.178	3277333.715	+1.5'
	P155	13686317.974	3277362.442	+3'
	P156	13686299.181	3277403.330	+3'
	P157	13686286.497	3277430.926	+1.5'
B19	P158	13686273.814	3277458.521	+3'
	P159	13686244.207	3277457.358	+1.5'
	P160	13686214.601	3277456.196	+3'
	P161	13686169.635	3277454.430	+3'
	P162	13686142.156	3277453.351	+1.5'
B20	P163	13686114.678	3277452.272	+3'
	P164	13686087.199	3277451.193	+1.5'
	P165	13686059.720	3277450.114	+3'
	P166	13686014.755	3277448.348	+3'
	P167	13685988.525	3277447.318	+1.5'
B21	P168	13685962.295	3277446.288	+3'
	P169	13685936.065	3277445.258	+1.5'
	P170	13685909.836	3277444.228	+3'
	P171	13685859.775	3277434.873	+3'
	P172	13685836.734	3277429.115	+1.5'
	P173	13685813.693	3277423.356	+3'
	P174	13685790.651	3277417.597	+1.5'
	P175	13685767.610	3277411.838	+3'

SEE DRAWING G103  
MATCH LINE STA. 43+60

SEE DRAWING G105  
MATCH LINE STA. 61+93

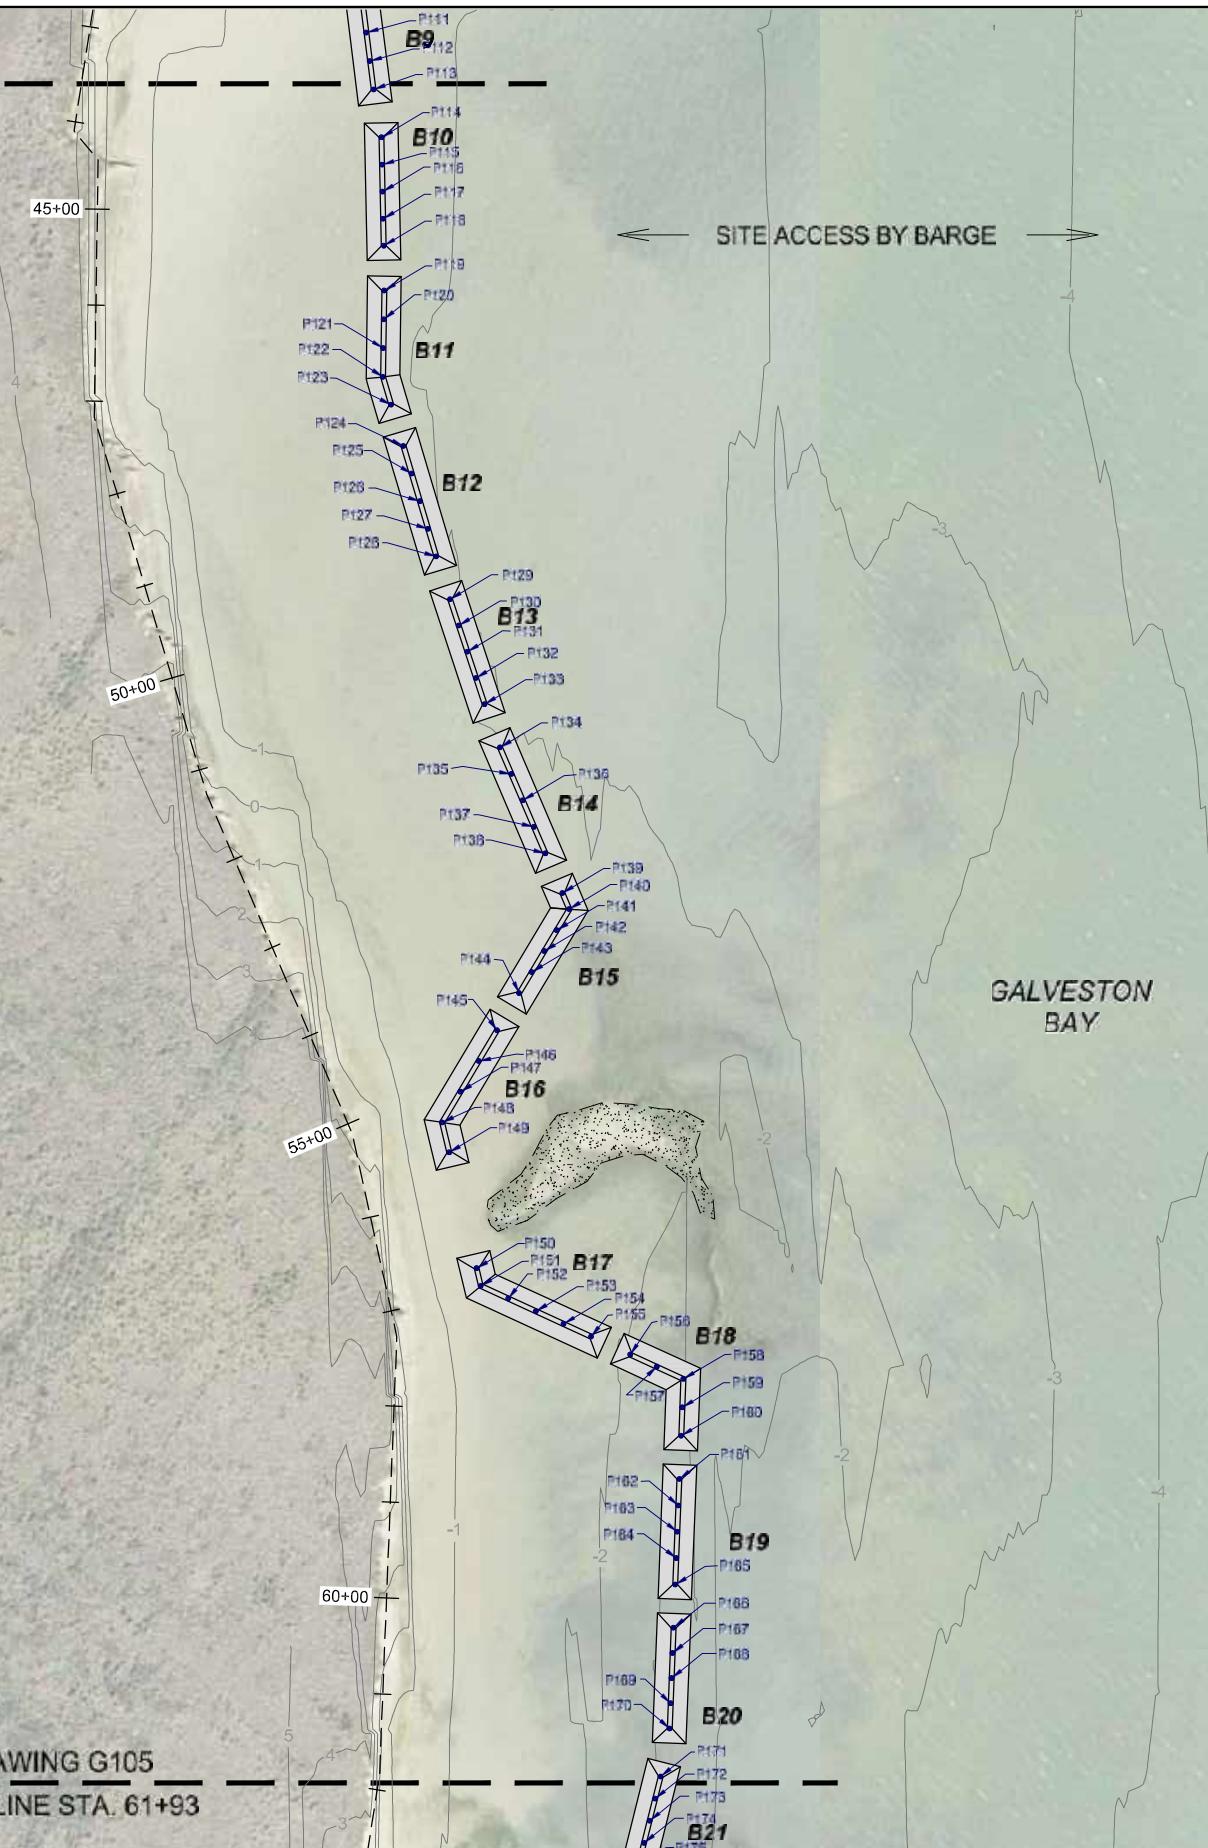

SITE ACCESS BY BARGE

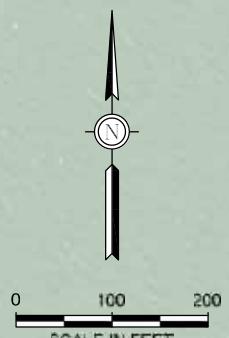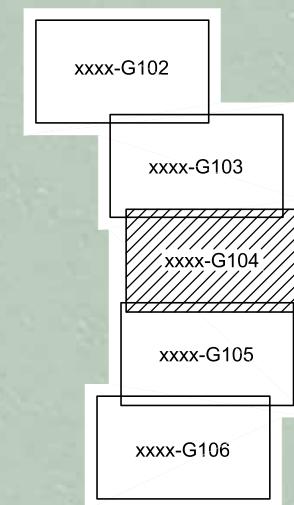

STATE OF TEXAS  
CHRISTOPHER P. LEVITZ  
107494  
LICENSED PROFESSIONAL ENGINEER  
AECOM  
FIRM REGISTRATION No. 3580

#### LEGEND:

- A** BREAKWATER DESIGNATION
- 2— EXISTING CONTOUR (CONTOUR INTERVAL = 1 FOOT)
- 10+00 SURVEY BASELINE STATIONING
- BREAKWATER "A" FOOTPRINT
- BREAKWATER "B" FOOTPRINT
- BREAKWATER "R" FOOTPRINT
- OYSTER REEFS

#### GENERAL NOTES:

1. SURVEY COMPLETED ON MARCH 10-11, 2013 BY NAISMITHE MARINE SERVICES. HORIZONTAL DATUM IS NAD83, TEXAS SOUTH CENTRAL ZONE, US FEET. VERTICAL DATUM IS NAVD'88, US FEET.
- REFERENCE CONTROL MONUMENTS:  
 '3200 L 5800'  
 NORTH: 13,691,249.77' EAST: 3,273,882.22'  
 ELEV: 7.33'
- '1488 C 2012'  
 NORTH: 13,680,977.18' EAST: 3,275,184.41'  
 ELEV: 11.93'  
 MHHW: 1.03' MLW: 0.96'  
 MLW: -0.02' MLW: -0.21'
2. MAINTAIN A BUFFER DISTANCE OF 50 FEET FROM THE OYSTER REEFS AT ALL TIMES.

REFERENCES	REV	DESCRIPTION	CHECKED BY	DATE	REV	DESCRIPTION	CHECKED BY	DATE

DRAWING SCALE 1" = 200'								
REFERENCE NAMES								DATE
DESIGNED BY:	TN	8/4/14						
DRAWN BY:	NAB	8/4/14						
CHECKED BY:	CL	10/26/15						
APPROVED BY:	CL	10/26/15						
FILE:	U:\PROJECTS\WTR\6043394_VrgPntCon\Drawings\ACAD\G103.dwg							

**AECOM**

GENERAL LAND OFFICE / SCENIC GALVESTON, INC.  
VIRGINIA POINT WETLAND PROTECTION PROJECT  
GALVESTON COUNTY, TEXAS  
BREAKWATER COORDINATES  
STA. 43+60 TO STA. 61+93  
1596-G104


JOB NO.  
6043394  
REVISION  
5  
DRAWING NO.  
1596-G104



BREAKWATER NO.	POINT NO.	NORTHING COORDINATE	EASTING COORDINATE	CREST ELEVATION
B33	P235	13684164.766	3276887.302	+3'
	P236	13684141.029	3276886.463	+1.5'
	P237	13684117.291	3276885.624	+3'
	P238	13684093.554	3276884.785	+1.5'
	P239	13684069.817	3276883.946	+3'
B34	P240	13684021.035	3276872.918	+3'
	P241	13683993.045	3276863.601	+1.5'
	P242	13683965.055	3276854.285	+3'
B35	P243	13683920.451	3276836.997	+3'
	P244	13683898.098	3276825.802	+1.5'
	P245	13683875.745	3276814.607	+3'
	P246	13683853.391	3276803.412	+1.5'
	P247	13683831.038	3276792.217	+3'
B36	P248	13683790.802	3276772.065	+3'
	P249	13683768.449	3276760.870	+1.5'
	P250	13683746.095	3276749.675	+3'
	P251	13683723.742	3276738.480	+1.5'
	P252	13683701.389	3276727.285	+3'
B37	P253	13683657.422	3276708.934	+3'
	P254	13683632.385	3276701.047	+1.5'
	P255	13683607.348	3276693.161	+3'
	P256	13683582.311	3276685.274	+1.5'
	P257	13683557.273	3276677.388	+3'
B38	P258	13683514.352	3276663.868	+3'
	P259	13683485.738	3276654.855	+1.5'
	P260	13683457.124	3276645.842	+3'
	P261	13683428.510	3276636.829	+1.5'
	P262	13683399.896	3276627.816	+3'
B39	P263	13683356.975	3276614.296	+3'
	P264	13683328.361	3276605.283	+1.5'
	P265	13683299.747	3276596.270	+3'
	P266	13683271.133	3276587.257	+1.5'
	P267	13683242.519	3276578.244	+3'
B40	P268	13683199.598	3276564.724	+3'
	P269	13683171.056	3276555.726	+1.5'
	P270	13683142.432	3276546.662	+3'
	P271	13683113.808	3276537.598	+1.5'
	P272	13683085.102	3276528.469	+3'
B41	P273	13683040.266	3276516.098	+3'
	P274	13683013.899	3276510.453	+1.5'
	P275	13682987.532	3276504.808	+3'
	P276	13682961.165	3276499.163	+1.5'
	P277	13682934.798	3276493.518	+3'
B42	P278	13682890.322	3276484.628	+3'
	P279	13682874.182	3276481.516	+1.5'
	P280	13682861.994	3276466.412	+3'
	P281	13682849.806	3276451.308	+1.5'
	P282	13682837.618	3276436.204	+3'
B43	P283	13682809.392	3276401.157	+3'
	P284	13682798.394	3276387.544	+1.5'
	P285	13682787.396	3276373.932	+3'
	P286	13682776.398	3276360.320	+1.5'
	P287	13682765.401	3276346.707	+3'
B44	P288	13682737.366	3276311.506	+3'
	P289	13682721.710	3276292.048	+1.5'
	P290	13682706.054	3276272.591	
	P291	13682690.398	3276253.133	+3'
	P292	13682672.868	3276255.586	+1.5'
	P293	13682655.338	3276258.039	+3'
PROJECT SIGN #4 (FIELD ADJUST AS NECESSARY)		13682640.326	3276301.310	N/A

SEE DRAWING G105

MATCH LINE STA. 81+91

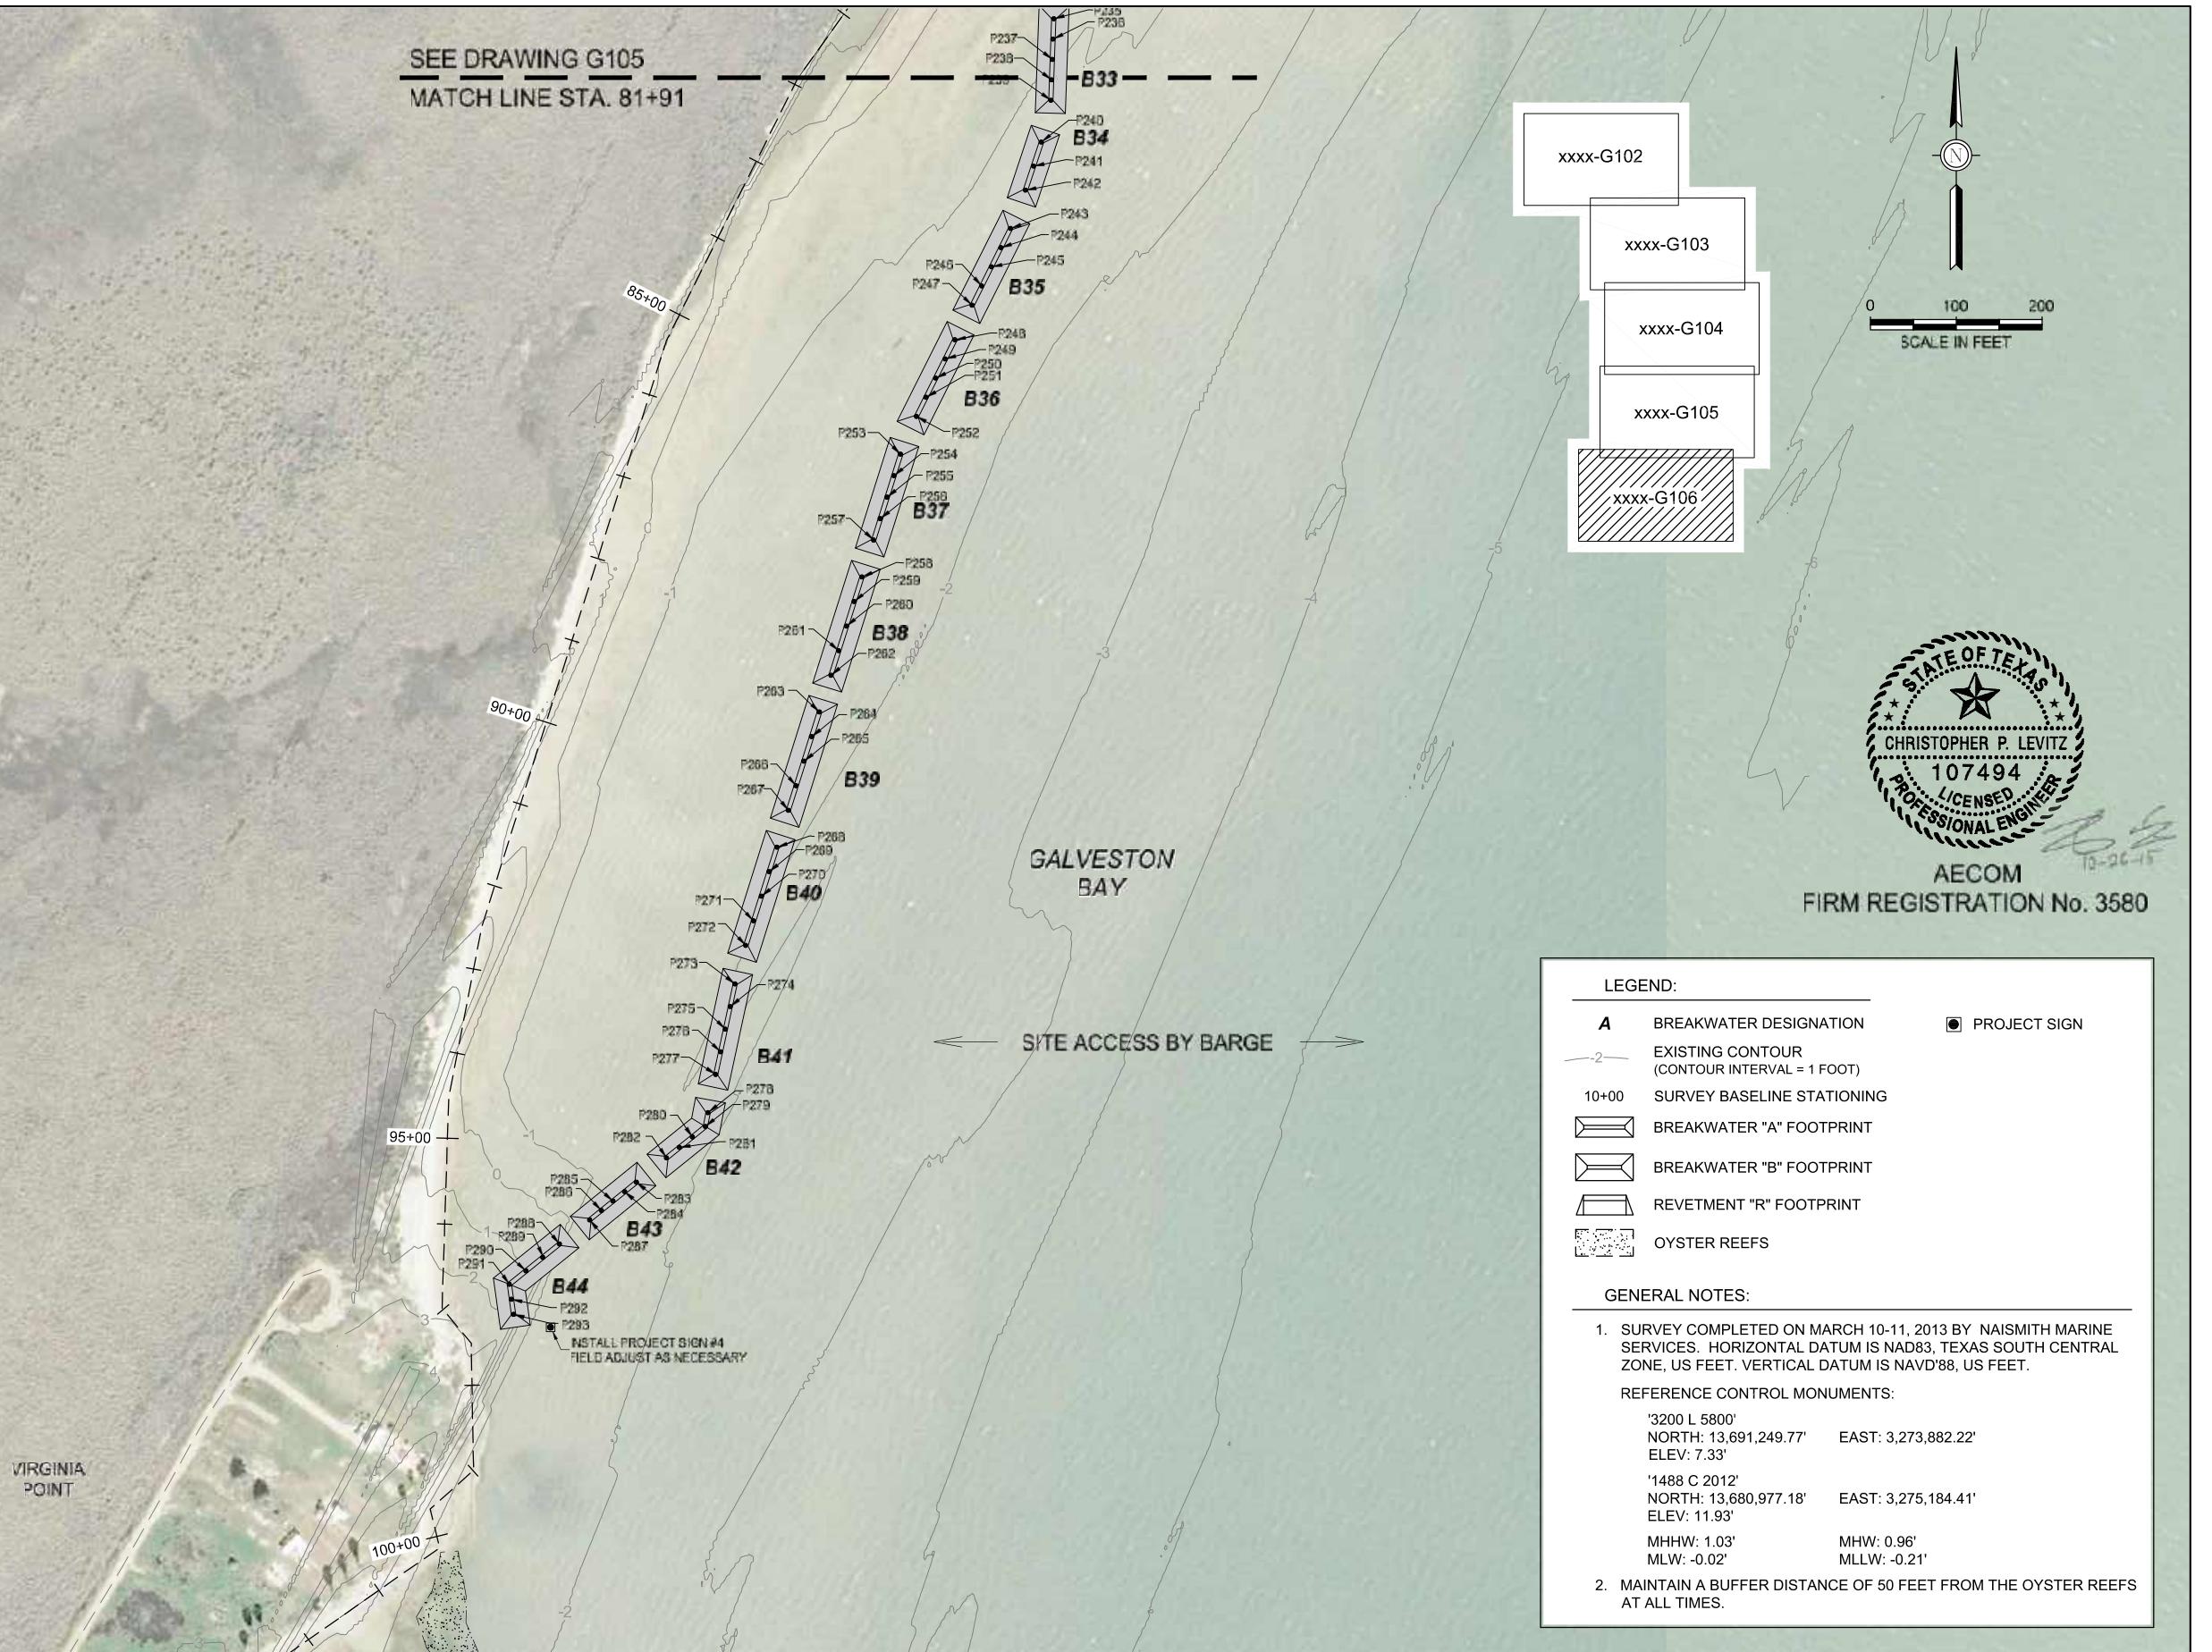

AECOM  
FIRM REGISTRATION No. 3580

**LEGEND:**

- |   |   |  |
|---|---|--|
| <b>A</b>  | BREAKWATER DESIGNATION                          | <input checked="" type="checkbox"/> PROJECT SIGN |
| <u>—-2—</u>   | EXISTING CONTOUR<br>(CONTOUR INTERVAL = 1 FOOT) |  |
| 10+00   | SURVEY BASELINE STATIONING                      |  |
|  | BREAKWATER "A" FOOTPRINT                        |  |
|  | BREAKWATER "B" FOOTPRINT                        |  |
|  | REVETMENT "R" FOOTPRINT                         |  |
|  | OYSTER REFFES                                   |  |

#### GENERAL NOTES:

1. SURVEY COMPLETED ON MARCH 10-11, 2013 BY NAISMITH MARINE SERVICES. HORIZONTAL DATUM IS NAD83, TEXAS SOUTH CENTRAL ZONE, US FEET. VERTICAL DATUM IS NAVD'88, US FEET.

#### REFERENCE CONTROL MONUMENTS:

'3200 L 5800'  
NORTH: 13,691,249.77' EAST: 3,273,882.22'  
ELEV: 7.33'  
  
'1488 C 2012'  
NORTH: 13,680,977.18' EAST: 3,275,184.41'  
ELEV: 11.93'  
  
MHHW: 1.03' MHW: 0.96'  
MLW: 0.02' MLW: 0.21'

2. MAINTAIN A BUFFER DISTANCE OF 50 FEET FROM THE OYSTER REEFS AT ALL TIMES

PROJECTS WORKED ON		REF ID		REV		DESCRIPTION		CHECKED BY		DATE		
S/N	ITEM											CHECKED BY
		0	70 % DESIGN	EL	9/13/13	1	95 % DESIGN	EL				
	REFERENCES		REV		DESCRIPTION		CHECKED BY	DATE	REV		DESCRIPTION	CHECKED BY

9/19/16	DRAWING SCALE REFERENCE NAMES	1" = 200' DATE
7/15/16	DESIGNED BY:	TN
10/26/15	DRAWN BY:	NAB
9/25/15	CHECKED BY:	CL
8/4/14	APPROVED BY:	CL
7/1/14		10/26/15
DATE	FILE #	PROJECT#W10453504, WRIGHTONCONTRACTOR/ACAD2016_AS-BUILT150K C:\USERS\WRIGHTON\DESKTOP\WRIGHTONCONTRACTOR\ACAD2016_AS-BUILT150K.DWG

AECOM

GENERAL LAND OFFICE / SCENIC GALVESTON, INC. VIRGINIA POINT WETLAND PROTECTION PROJECT GALVESTON COUNTY, TEXAS		JOB NO. 60433394
		REVISION 6
BREAKWATER COORDINATES STA. 81+91 TO STA. 102+00		DRAWING NO. 1596-G106





File: O:\Projects\WTR\6043394\_Virginia Point Wetland Protection Project\DWG\Site Plan - Breakwater B and A1 - Revised.dwg Layout: C101 User: toylor.nordstrom Pictet: Sep 20, 2016 - 3:43pm

REFERENCES	REV	DESCRIPTION	CHECKED BY	DATE	REV	DESCRIPTION	CHECKED BY	DATE
2	ISSUE FOR CONSTRUCTION	EL	8/6/14	5	AS-BUILTS	CL	9/19/16	
1	95 % DESIGN	EL	7/1/14	4	ENGINEER'S SUPPLEMENTAL INSTRUCTIONS #3	CL	9/6/16	
0	70 % DESIGN	EL	9/13/13	3	ENGINEER'S SUPPLEMENTAL INSTRUCTIONS #2	CL	8/18/16	
					CHANGE ORDER #2 - PROJECT SIGNAGE	CL	7/15/16	
					RE-ISSUE FOR BID	CL	10/26/15	
					ISSUE FOR REVIEW	CL	9/25/15	

**DRAWING SCALE 1" = 200'**

**REFERENCE NAMES DATE**

**DESIGNED BY: TN 8/4/14**

**DRAWN BY: NAB 8/4/14**

**CHECKED BY: CL 10/26/15**

**APPROVED BY: CL 10/26/15**

**FILE: \PROJECTS\WTR\6043394\_VIRGINIA POINT WETLAND PROTECTION PROJECT\DWG\Site Plan - Breakwater B and A1 - Revised.DWG**

**GENERAL LAND OFFICE / SCENIC GALVESTON, INC.**  
**VIRGINIA POINT WETLAND PROTECTION PROJECT**  
**GALVESTON COUNTY, TEXAS**

**AECOM**

**SITE PLAN - STA. 20+73 TO STA. 43+60**

**JOB NO. 6043394**

**REVISION 8**

**DRAWING NO. 1596-C101**




SEE DRAWING C102  
MATCH LINE STA. 61+93



File: C:\Projects\WTR\60433594\_VirginPointCon\DWg\DWGACAD\2016\_As-Built\1596 - C100\_C104 - Site Plan - Breakwater B and A1 - Revised.dwg Plotter: Sep 20, 2016 - 3:43pm User: taylor.mordstrom Layout: C103 User: C103 Date: 10/26/2015



SEE DRAWING C104  
MATCH LINE STA. 81+91

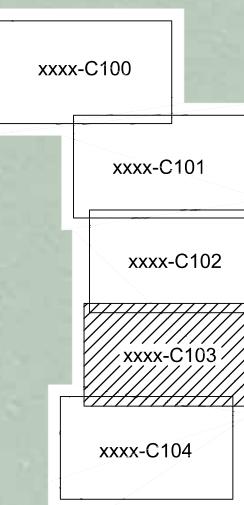

GALVESTON  
BAY



*[Signature]*  
10-26-15

AECOM  
FIRM REGISTRATION No. 3580

#### LEGEND:

- A** BREAKWATER DESIGNATION
- 2-** EXISTING CONTOUR (CONTOUR INTERVAL = 1 FOOT)
- 10+00** SURVEY BASELINE STATIONING
- B20** BREAKWATER "A" FOOTPRINT
- B21** BREAKWATER "B" FOOTPRINT
- R** REVETMENT "R" FOOTPRINT
- REEF** OYSTER REEFS
- PS** PROJECT SIGN

#### GENERAL NOTES:

1. SURVEY COMPLETED ON MARCH 10-11, 2013 BY NAISMITH MARINE SERVICES. HORIZONTAL DATUM IS NAD83, TEXAS SOUTH CENTRAL ZONE, US FEET. VERTICAL DATUM IS NAVD'88, US FEET.
- REFERENCE CONTROL MONUMENTS:
 

'3200 L 5800'	
NORTH: 13,691,249.77'	EAST: 3,273,882.22'
ELEV: 7.33'	

'1488 C 2012'	
NORTH: 13,680,977.18'	EAST: 3,275,184.41'
ELEV: 11.93'	

MHHW: 1.03'	MHW: 0.96'
MLW: -0.02'	MLLW: -0.21'
2. BASE BID: BREAKWATERS 'A1' - 'A17' AND 'B1' - 'B44' OPTIONAL ADDITIVE I: REVETMENT 'R1'
3. MAINTAIN A BUFFER DISTANCE OF 50 FEET FROM THE OYSTER REEFS AT ALL TIMES.

DRAWING SCALE		1" = 200'
REFERENCE NAMES		DATE
DESIGNED BY:	TN	8/4/14
DRAWN BY:	NAB	8/4/14
CHECKED BY:	CL	10/26/15
APPROVED BY:	CL	10/26/15
FILE:	PROJECTSWTR60433594_VIRGPNTCON\DWG\DWGACAD\2016_As-Built\1596 - C100_C104 - SITE PLAN - BREAKWATER B AND A1 - REVISED.DWG	

**AECOM**

GENERAL LAND OFFICE / SCENIC GALVESTON, INC.  
VIRGINIA POINT WETLAND PROTECTION PROJECT  
GALVESTON COUNTY, TEXAS  
  
DRAWS NO. 6  
  
SITE PLAN - STA. 61+93 TO STA. 81+91  
1596-C103



File: O:\Projects\WTR\6043394\VirgPntCon.Dwg\Acad2016\_As-Built\1596 - C100\_C104 - Site Plan - Breakwater B and A1 - Revised.dwg Layout: C104 User: toylor.nordstrom Pictlet: Sep 20, 2016 - 3:43pm

0	70 % DESIGN	EL	9/13/13	1	95 % DESIGN	CL	9/19/16	DRAWING SCALE 1" = 200'	GENERAL LAND OFFICE / SCENIC GALVESTON, INC. VIRGINIA POINT WETLAND PROTECTION PROJECT GALVESTON COUNTY, TEXAS
REFERENCES	REV	DESCRIPTION	CHECKED BY	DATE	REV	DESCRIPTION	CHECKED BY	DATE	JOB NO. 6043394
							REFERENCE NAMES	DATE	REVISION 6
							DESIGNED BY:	TN 8/4/14	DRAWING NO. 1596-C104
							DRAWN BY:	NAB 8/4/14	
							CHECKED BY:	CL 10/26/15	
							APPROVED BY:	CL 10/26/15	
							FILE:	PROJECTSWTR\6043394\VirgPntCon.Dwg\Acad2016_As-Built\1596 - C100_C104 - SITE PLAN - BREAKWATER B AND A1 - REVISED.DWG	

**AECOM**

GENERAL LAND OFFICE / SCENIC GALVESTON, INC.  
VIRGINIA POINT WETLAND PROTECTION PROJECT  
GALVESTON COUNTY, TEXAS

SITE PLAN - STA. 81+91 TO STA. 102+00